

photo #2

Camion de raclage

decoking truck





SAP#

302004099

CODE DE SERVICE

B1001

DESCRIPTION

SECTION CONVECTION ET RADIANT DE B1001

passes "A" et "D"


*Circuit de
dicokage #2*

passes "B" et "C"

*Circuit de
dicokage #1**B-1001
Annét 2015*

SA 213 T5

SA 213 T9

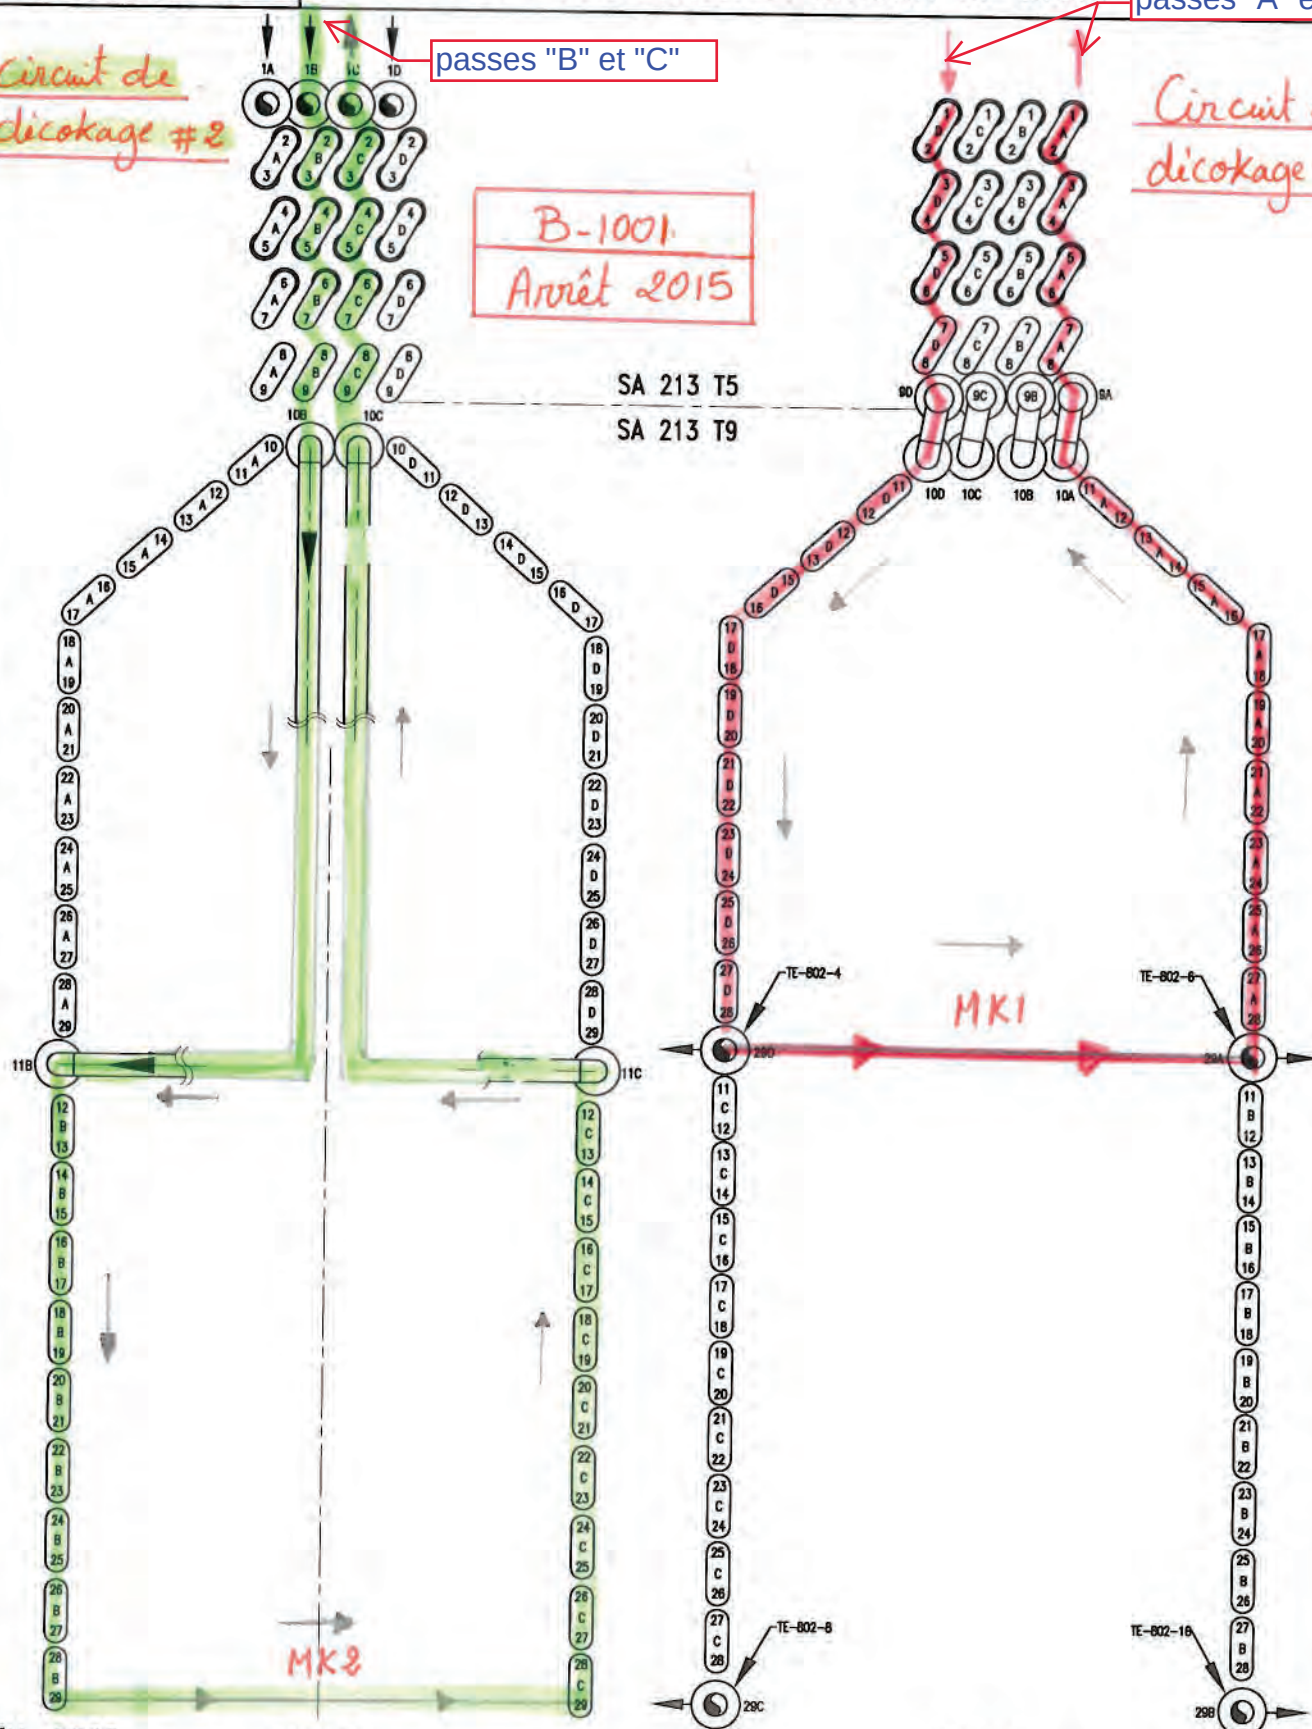



FÉV. 2005

ENTRÉE
(EXTREMITÉ NORD)

D.M.

SORTIE
(EXTREMITÉ SUD)


Rev.0

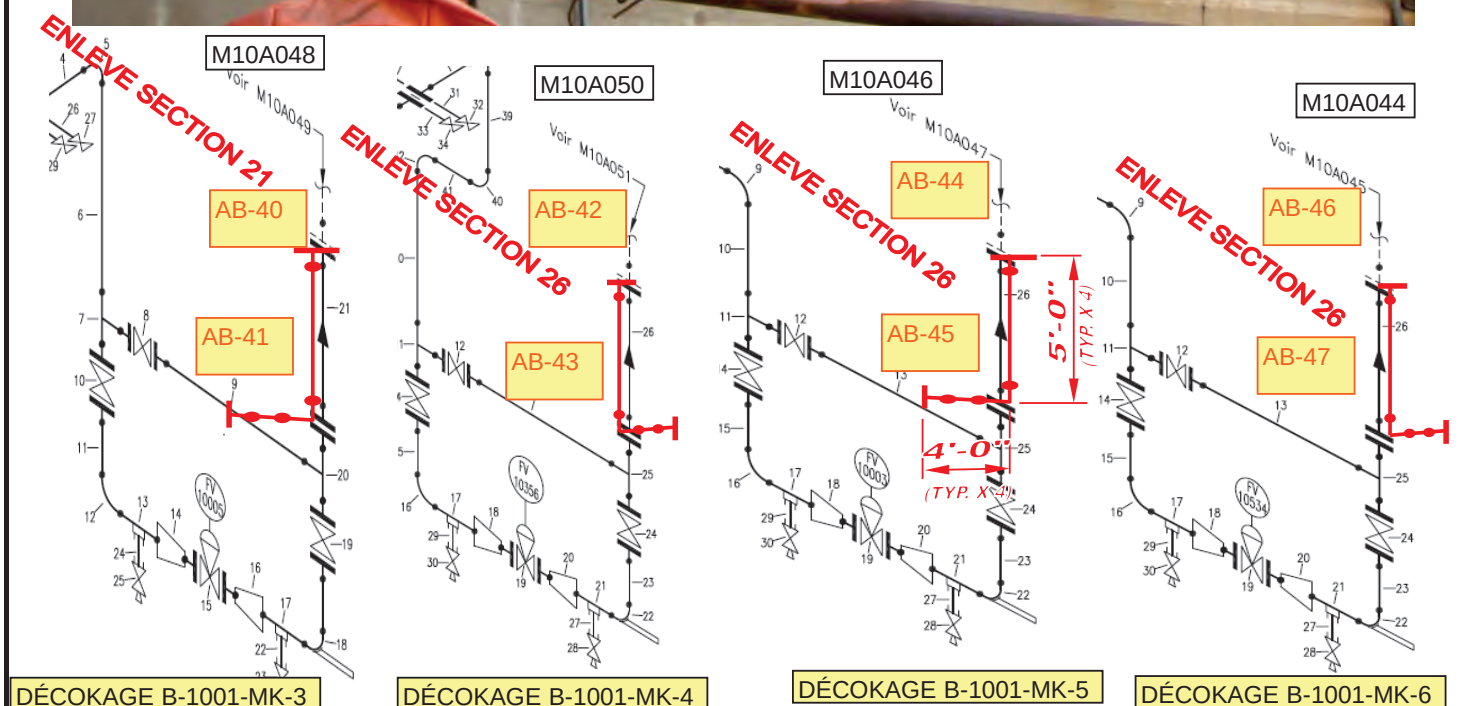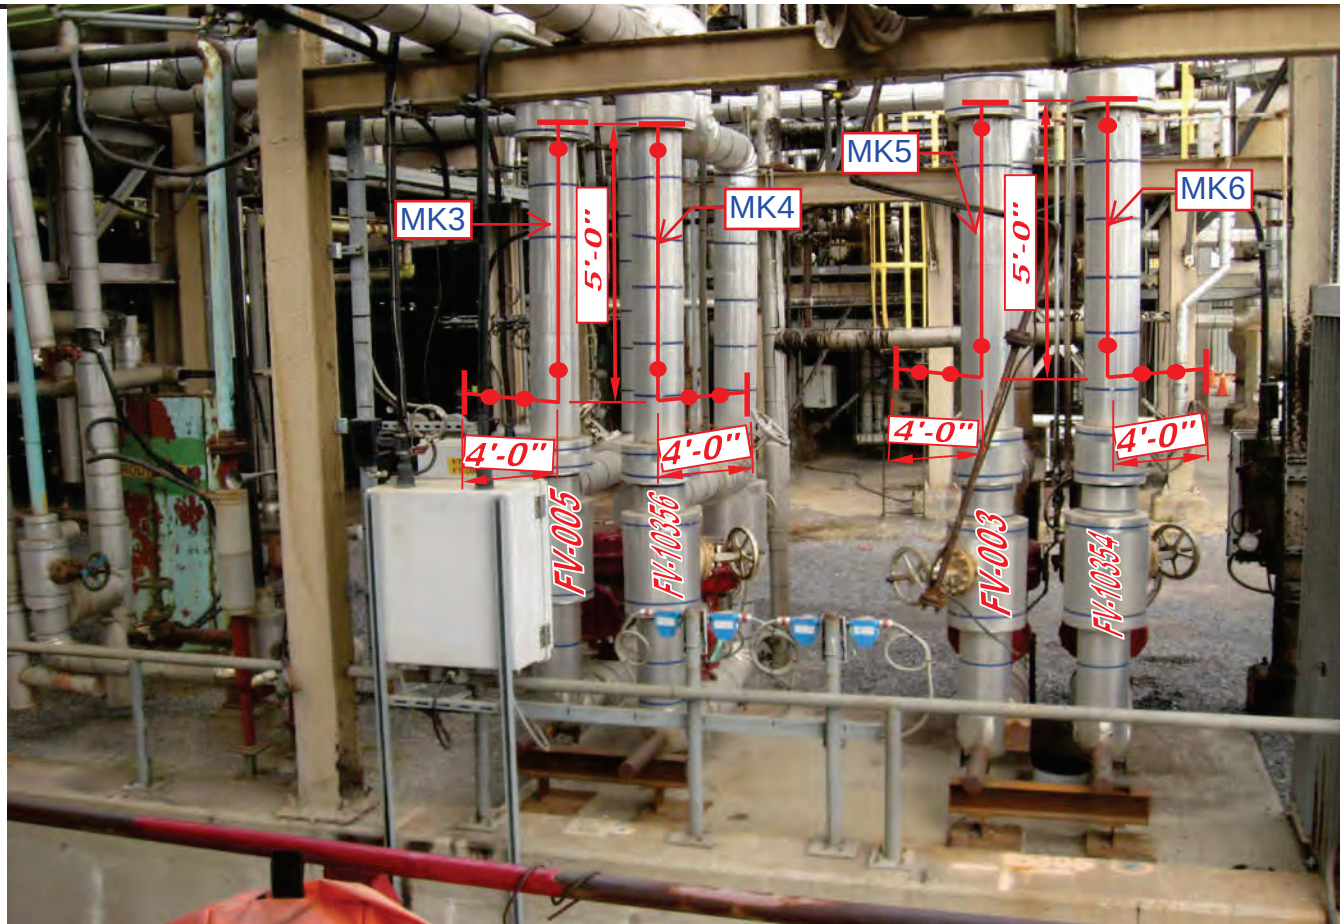


CODE DE SERVICE:		FOUR DE BRUT-B-1001	
AVIS#	905083360	ARRÊT 2021	ORDRE# 60093250

DESCRIPTION SOMMAIRE DES TRAVAUX:

- * PROCÉDER À L'OBTURATION POUR LE DÉCOKAGES.
- * INSTALLATION DES ÉQUIPEMENT POUR DÉCOKAGES.
- * ENLEVER TOUTE L'INSTRUMENTATION SUR LE CIRCUIT DE DECOKAGE.
- * PROCÉDER AU DÉCOKAGES.

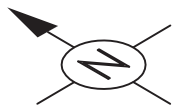

1230

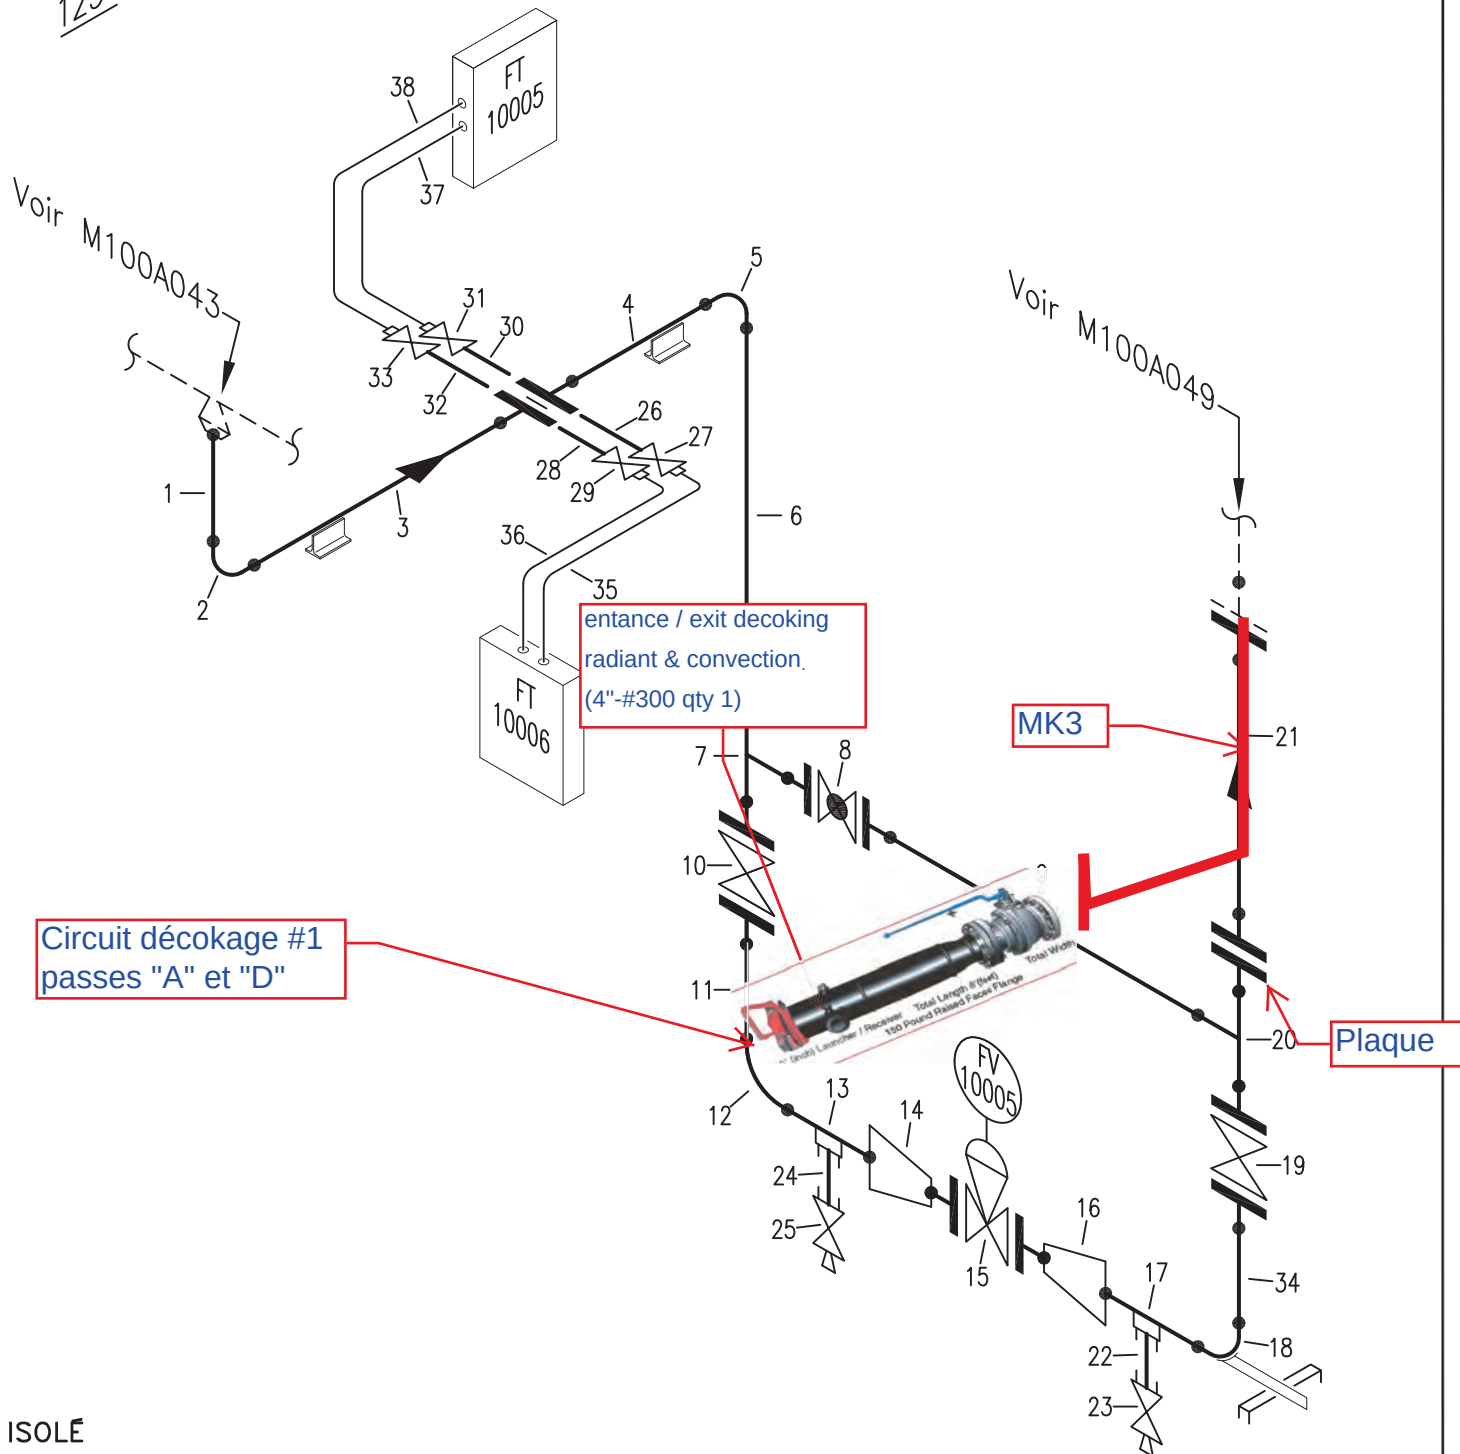

ISOLÉ
100-062D0005
100-O-680-1

MARS 2005

D.M.


01/2018-NL
04/2015-NL
Rev. 07/2011-NL

Rev.07/2011-NL

(O-661-4"-UD1)



1230

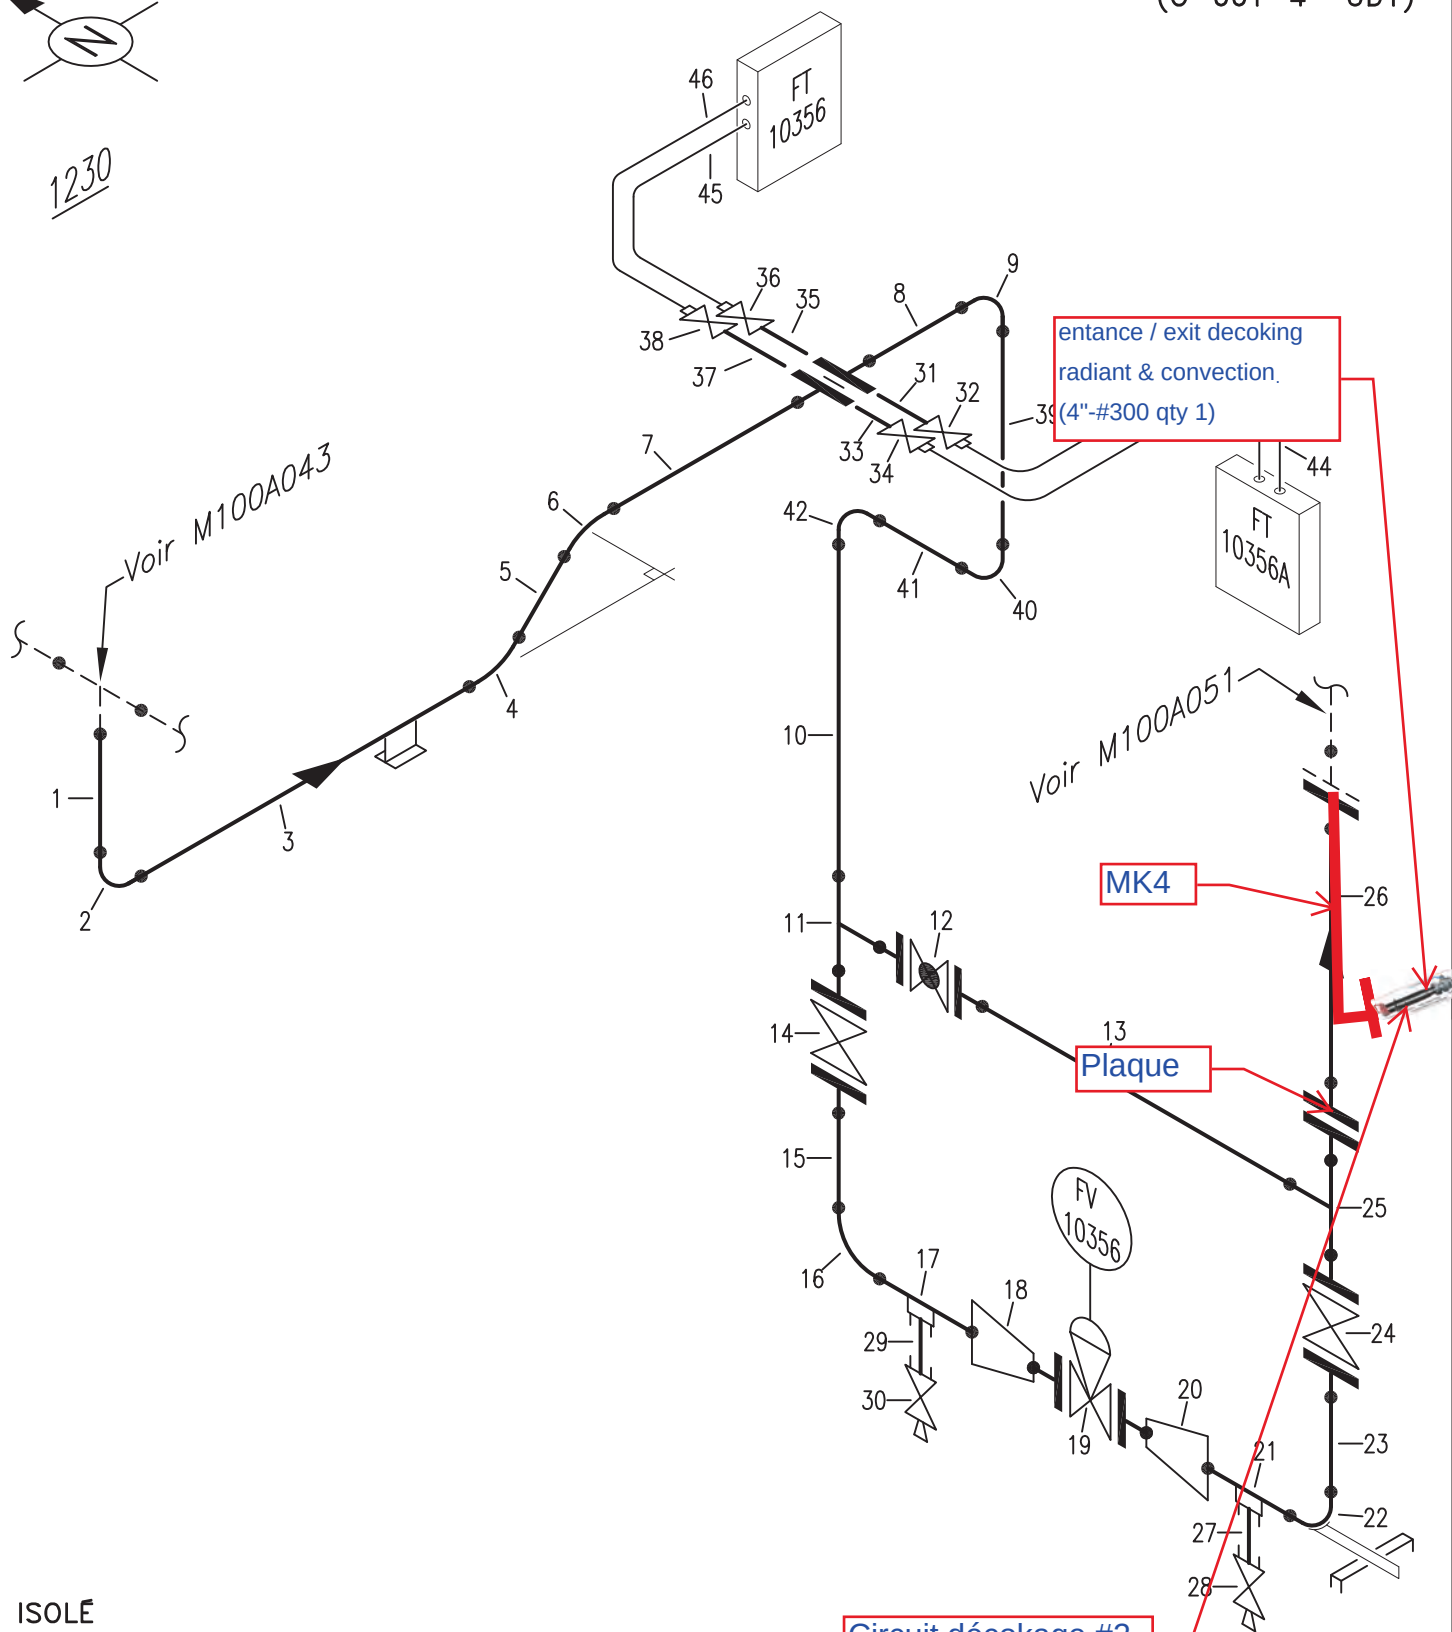

ISOLÉ


100-062D0005

100-O-661-1/2

MARS 2005

D.M.


01/2018-NL
04/2015-NL
Rev.03/2009-TP

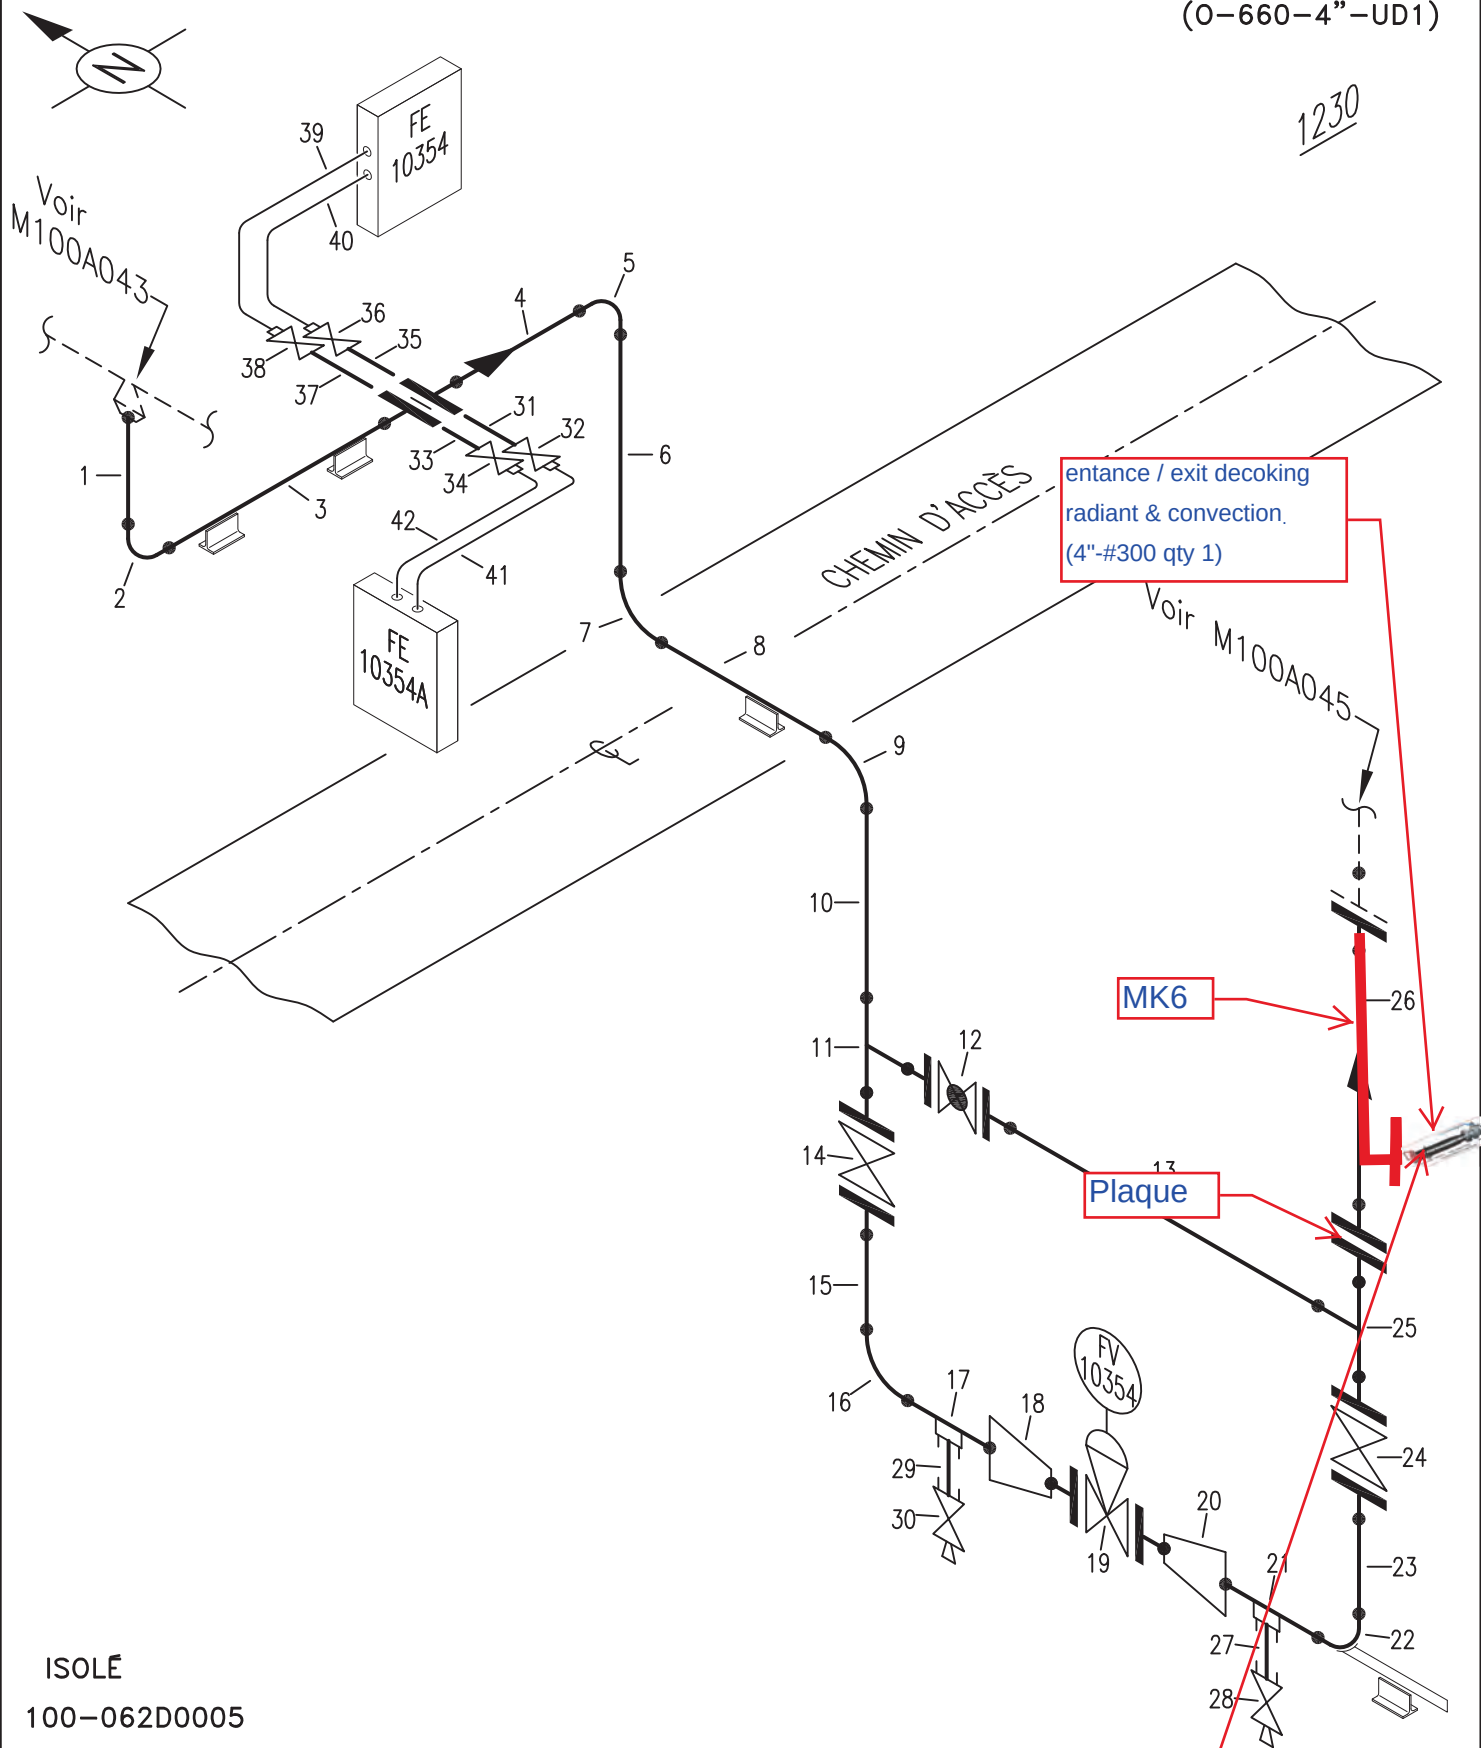

ISOLÉ
100-062D0005
100-O-660-1/2
MARS 2005
D.M.

Circuit décokage #2
passes "B" et "C"


01/2018-NL
04/2015-NL
01/2015-NL
Rev.07/2011-NL

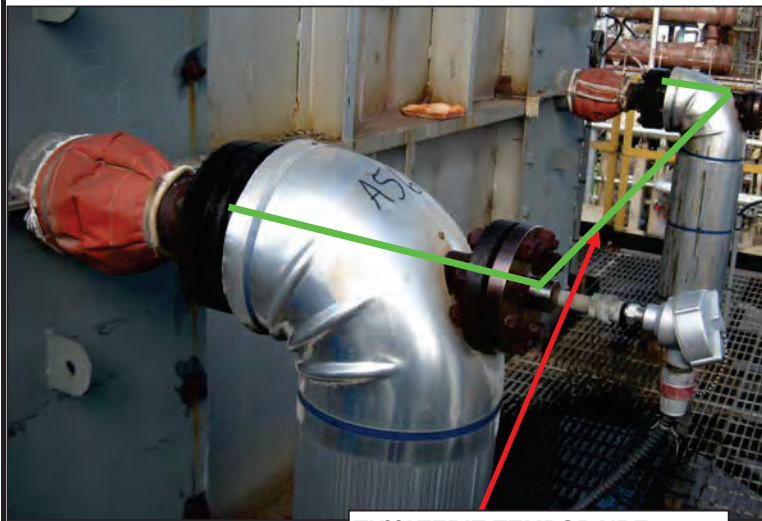

TUYATERIE TEMPORAIRE
BALCON 2 CÔTÉ SUD.




TUYATERIE TEMPORAIRE
BALCON 1 CÔTÉ SUD.

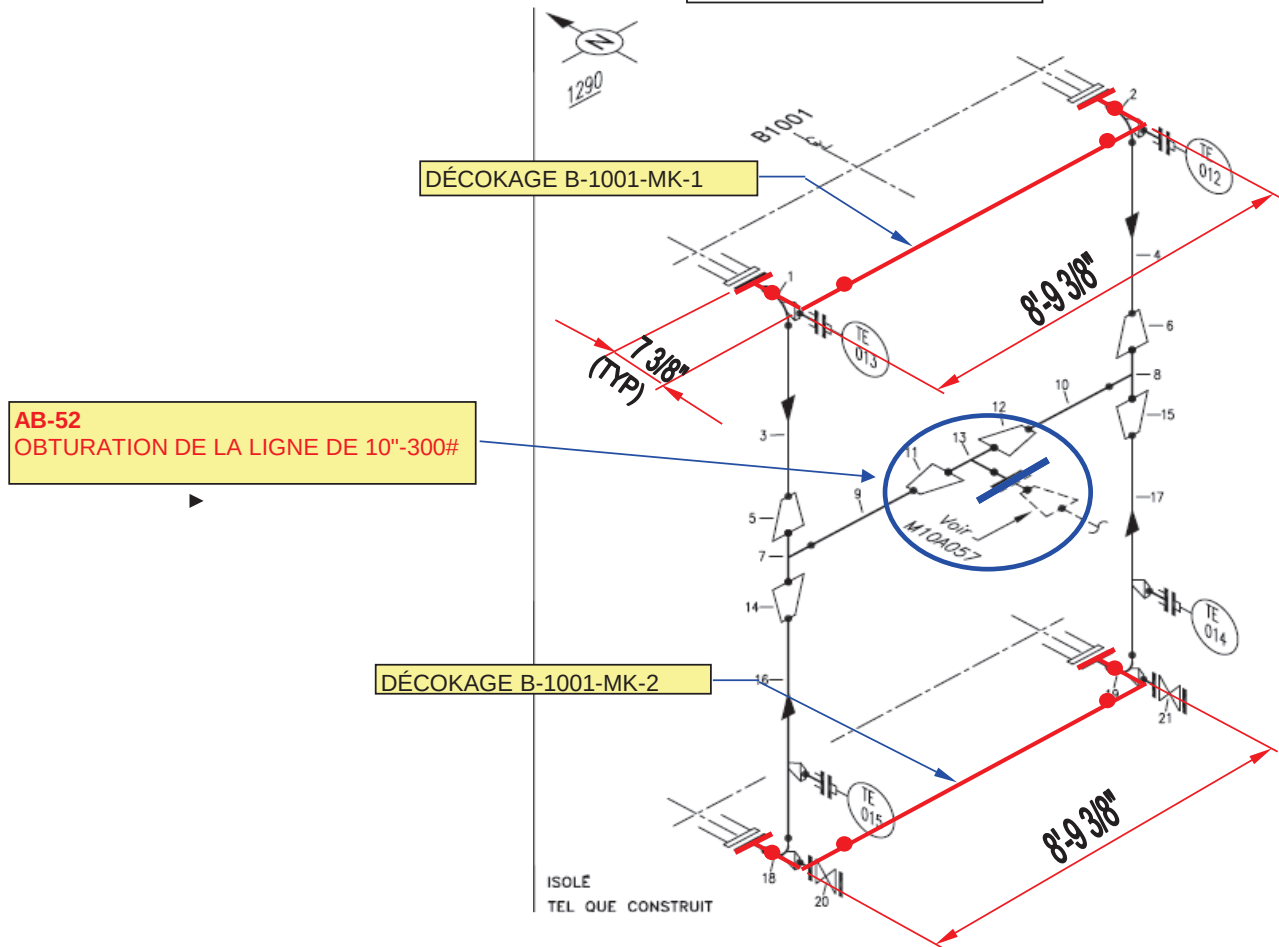

CODE DE SERVICE:		M01A056	FOUR DE BRUT-B-1001	
AVIS#	905083360	ARRÊT 2021	ORDRE#	60093250

DESCRIPTION SOMMAIRE DES TRAVAUX:

- * PROCÉDER À L'OBTURATION POUR LE DÉCOKAGES.
- * INSTALLATION DES ÉQUIPEMENT POUR DÉCOKAGES.
- * ENLEVER TOUTE L'INSTRUMENTATION SUR LE CIRCUIT DE DECOKAGE.
- * PROCÉDER AU DÉCOKAGES.


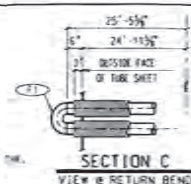


NDE REQUIREMENTS	
RT:	100% OF 100%
UT:	NR
MT:	NR
PT:	NR
PMI:	100%
BAW:	220 BAW

TUBE & PIPE BILL OF MATERIAL									
REV	MARK	QTY	FIN	DESCRIPTION SIZE X WALL	LENGTH FT	IN	END	MAT'L	LOCATE REMARKS
1A-1C	2	YES	41/2"	0.0 x .201" M.K. TUBE	53	60		S4173	2011
1B-1D	2	YES	41/2"	0.0 x .201" M.K. TUBE	33	20		S4173	2012
2A-40	20	YES	41/2"	0.0 x .201" M.K. TUBE	50	110		S4173	2013
1A-40	8	NO	41/2"	0.0 x .201" M.K. TUBE	51	110		S4173	2014
3A-9C	2	NO	41/2"	0.0 x .201" M.K. TUBE	54	78		S4173	2015
1B-9D	2	NO	41/2"	0.0 x .201" M.K. TUBE	51	80		S4173	2016
10A	1	NO	41/2"	0.0 x .201" M.K. TUBE	52	23		S4173	2017
10B	1	NO	41/2"	0.0 x .201" M.K. TUBE	55	0		S4173	2018
10C	1	NO	41/2"	0.0 x .201" M.K. TUBE	54	0		S4173	2019
10D	1	NO	41/2"	0.0 x .201" M.K. TUBE	52	88		S4173	2020
11A-29B	35	NO	41/2"	0.0 x .201" M.K. TUBE	49	0		S4173	2021
29A-29D	2	NO	41/2"	0.0 x .201" M.K. TUBE	51	30		S4173	2022
11B	1	NO	41/2"	0.0 x .201" M.K. TUBE	55	8		S4173	2023
11C	1	NO	41/2"	0.0 x .201" M.K. TUBE	52	2		S4173	2024
11E-12A	34	NO	41/2"	0.0 x .201" M.K. TUBE	49	0		S4173	2025
29E-29C	2	NO	41/2"	0.0 x .201" M.K. TUBE	51	80		S4173	2026
2E	1	NO	41/2"	0.0 x .201" M.K. TUBE	0	0		S4173	2027
3E	2	NO	41/2"	0.0 x .201" M.K. TUBE	0	0		S4173	2028
4E	2	NO	41/2"	0.0 x .201" M.K. TUBE	91	33		S4173	2029
5E	2	NO	41/2"	0.0 x .201" M.K. TUBE	5	33		S4173	2030
6E	4	NO	41/2"	0.0 x .201" M.K. TUBE	4	100		S4173	2031
7E	2	NO	6"	SCH. 40 PIPE	2	75		S4173	2032
8E	2	NO	41/2"	0.0 x .201" M.K. TUBE	0	50		S4173	2033


FITTINGS BILL of MATERIAL					
REV	MARK	QTY	DESCRIPTION	MATERIAL	LOCATE REMARK
F2	32	4	1" SCH. 40 STD. R. R. ELBOW 90°	A234-WPS	
F3	32	4	1" SCH. 40 STD. R. R. ELBOW 90°	A234-WPS	
F4	32	14	4" SCH. 40 90° S. R. ELBOW	A234-WPS	
F4	4	4	6" SCH. 40 90° L. R. ELBOW	A234-WPS	
F5	4	6	4" x 6" CONCENTRIC REDUCER 1/2 SCH. 40	A234-WPS	
F6	2	10	4" x 6" CONCENTRIC REDUCER 1/2 SCH. 40	A234-WPS	
F7	2	6	6" SCH. 40 TEE	A234-WPS	
F8	1	10	6" SCH. 40 TEE	A234-WPS	

810					
811	1	10" 300M RFWN F.L.G.	15CM. 40 BORE 1	A182-F3	
812	6	4" 300M RFWN F.L.G.	15CM. 40 BORE 1	A182-F3	
813	28	4" 300M RFWN F.L.G.	15CM. 40 BORE 1	A182-F3	
814	16	4" 300M EXTERNAL GASKETS	15CM-3L5	150455	
815	128	8" DIA. x 1/2" G. STUDS w/ 121 HEX NUTS	4" w/ 150455		
816	8	2" 300M RFWN F.L.G.	15CM. 40 BORE 1	A182-F3	
817	10	2" 300M SLIND F.L.G.		A182-F3	
818	10	2" 300M EXTERNAL GASKETS	15CM-3L5	150455	
819	80	8" DIA. x 1/2" G. STUDS w/ 121 HEX NUTS	4" w/ 150455		
820	4	2" OUTLET w/ 4" RUN ELBOWET (STD.)		A182-F3	
821	2	2" 300M RFWN F.L.G.	15CM 40 BORE 1 LONG	A182-F3	
822	4	2" OUTLET w/ 4" RUN ELBOWET L.R. (STD.)		A182-F3	
823					
824		SHIP LOOSE TO FIELD			
825		SHIP LOOSE TO FIELD - A 182			

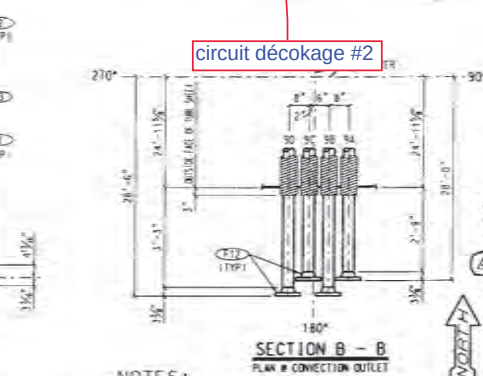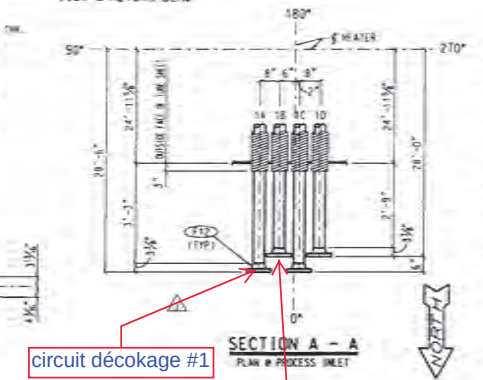[illegible]

NOTES:

7. ALL ALLOY THROAT PIPING AND FITTINGS WILL BE 300S P301 DESIGNED BY THOMAS HEADERS, INC.
8. ALL COOL WATERLINE MUST BE PROTECTED FROM PUMP AND ZINC CONTAMINATES DURING STORAGE, FABRICATION AND INSTALLATION. TUBES SHALL NOT COME IN CONTACT WITH GALVANIZED METAL AT ANYTIME. MINERAL OILS TO BE TEST IMMEDIATELY.
9. ALL WELD PROCEDURES ARE TO BE APPROVED PRIOR TO START OF WELDING.
10. PREHEAT AND POSTHEAT TREATMENT TO BE IN ACCORDANCE WITH APPROVED WELD PROCEDURES.
11. RADIOGRAPHY IS TO BE PERFORMED AFTER COMPLETION OF POSTHEAT TREATMENT.
12. FINISH FACE FINISH OF ALL PLANGED CONNECTIONS ON THE PROCESS COIL SHALL BE 125 ARMSIL.

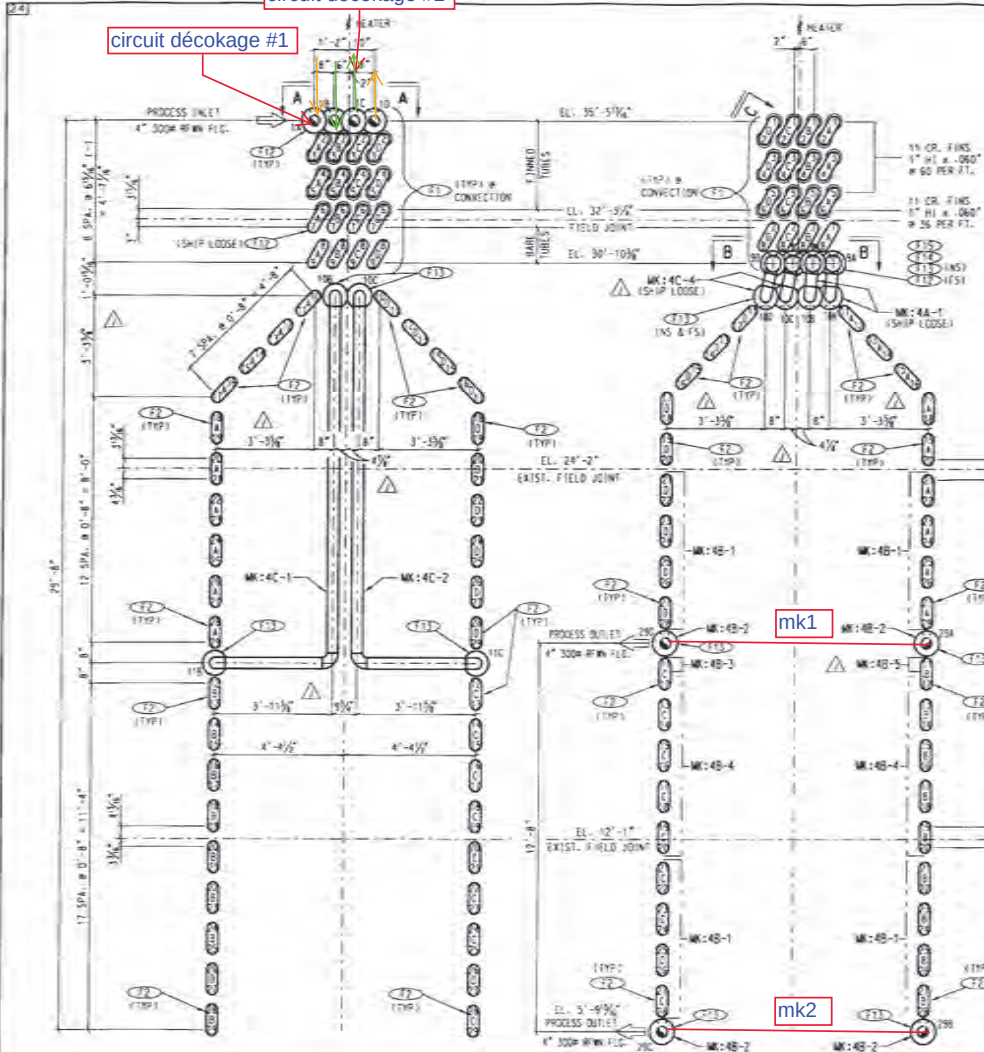


PROCESS INLET END
(NORTH END ELEVATION @ 0° AXIS)

PROCESS OUTLET END
(SOUTH END ELEVATION @ 180" ABOVE)

PROPRIETARY INFORMATION

The information and designs shown herein, including all patented and patentable features are the property of, proprietary and confidential to TULSA HEATERS, INC.. This document shall not be reproduced in whole or partly, or disseminated to any third party without the express written consent of TULSA HEATERS, INC.. All copies of this document, printed or electronic, are null and void if modified or altered in any way. Only TULSA HEATERS, INC. possesses the right of controlling operation of any design, style and shall govern over any copy, printed or electronic.

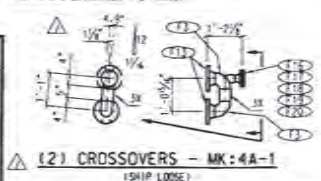


PROCESS COIL DATA	
OPER. CONDITION:	DESIGN CONDITIONS:
INLET 351° F. @ 142 PSIG	PRESSURE: 450 PSIG
OUTLET 610° F. @ 42.4 PSIG	FLUID TEMPERATURE: 760° F.
OUT 70.2% STEAM	PIPE WALL TEMPERATURE: 935° F.
	CORROSION ALLOWANCE: 0.125"
	SHOP HYDROTEST @ 1125 PSIG

Location	Rev	Date	By	Revised By	Revised Date
BANTREL CO. / PETRO-CANADA					
PROJECT : MONTREAL CRUDE RECONFIGURATION					
LOCATION : MONTREAL REFINERY					
UNIT : CRUDE DISTILLER					
SERVICE : CRUDE OIL HEATER					
EQUIP. No. : B-1001					
P.O. No. : 356-01B-COM-F-02A					
	3/92	BP	REV'D.	PER CUSTOMER COMMENTS	
	4/92	BP	REV'D.	PER CUSTOMER COMMENTS	
	5/92	BP	REV'D.	PER CUSTOMER COMMENTS	
	6/92	BP	REV'D.	PER CUSTOMER COMMENTS	

		TULSA HEATERS INC.	
COIL DETAILS			
Order By:	BP	Date:	1/30/04
Drawn By:	DH	Date:	2/5/04
Approved By:		Coil No.:	SI731-4A
		Ordering No.:	SI731-4A

Circuit décodage
#1 et #2

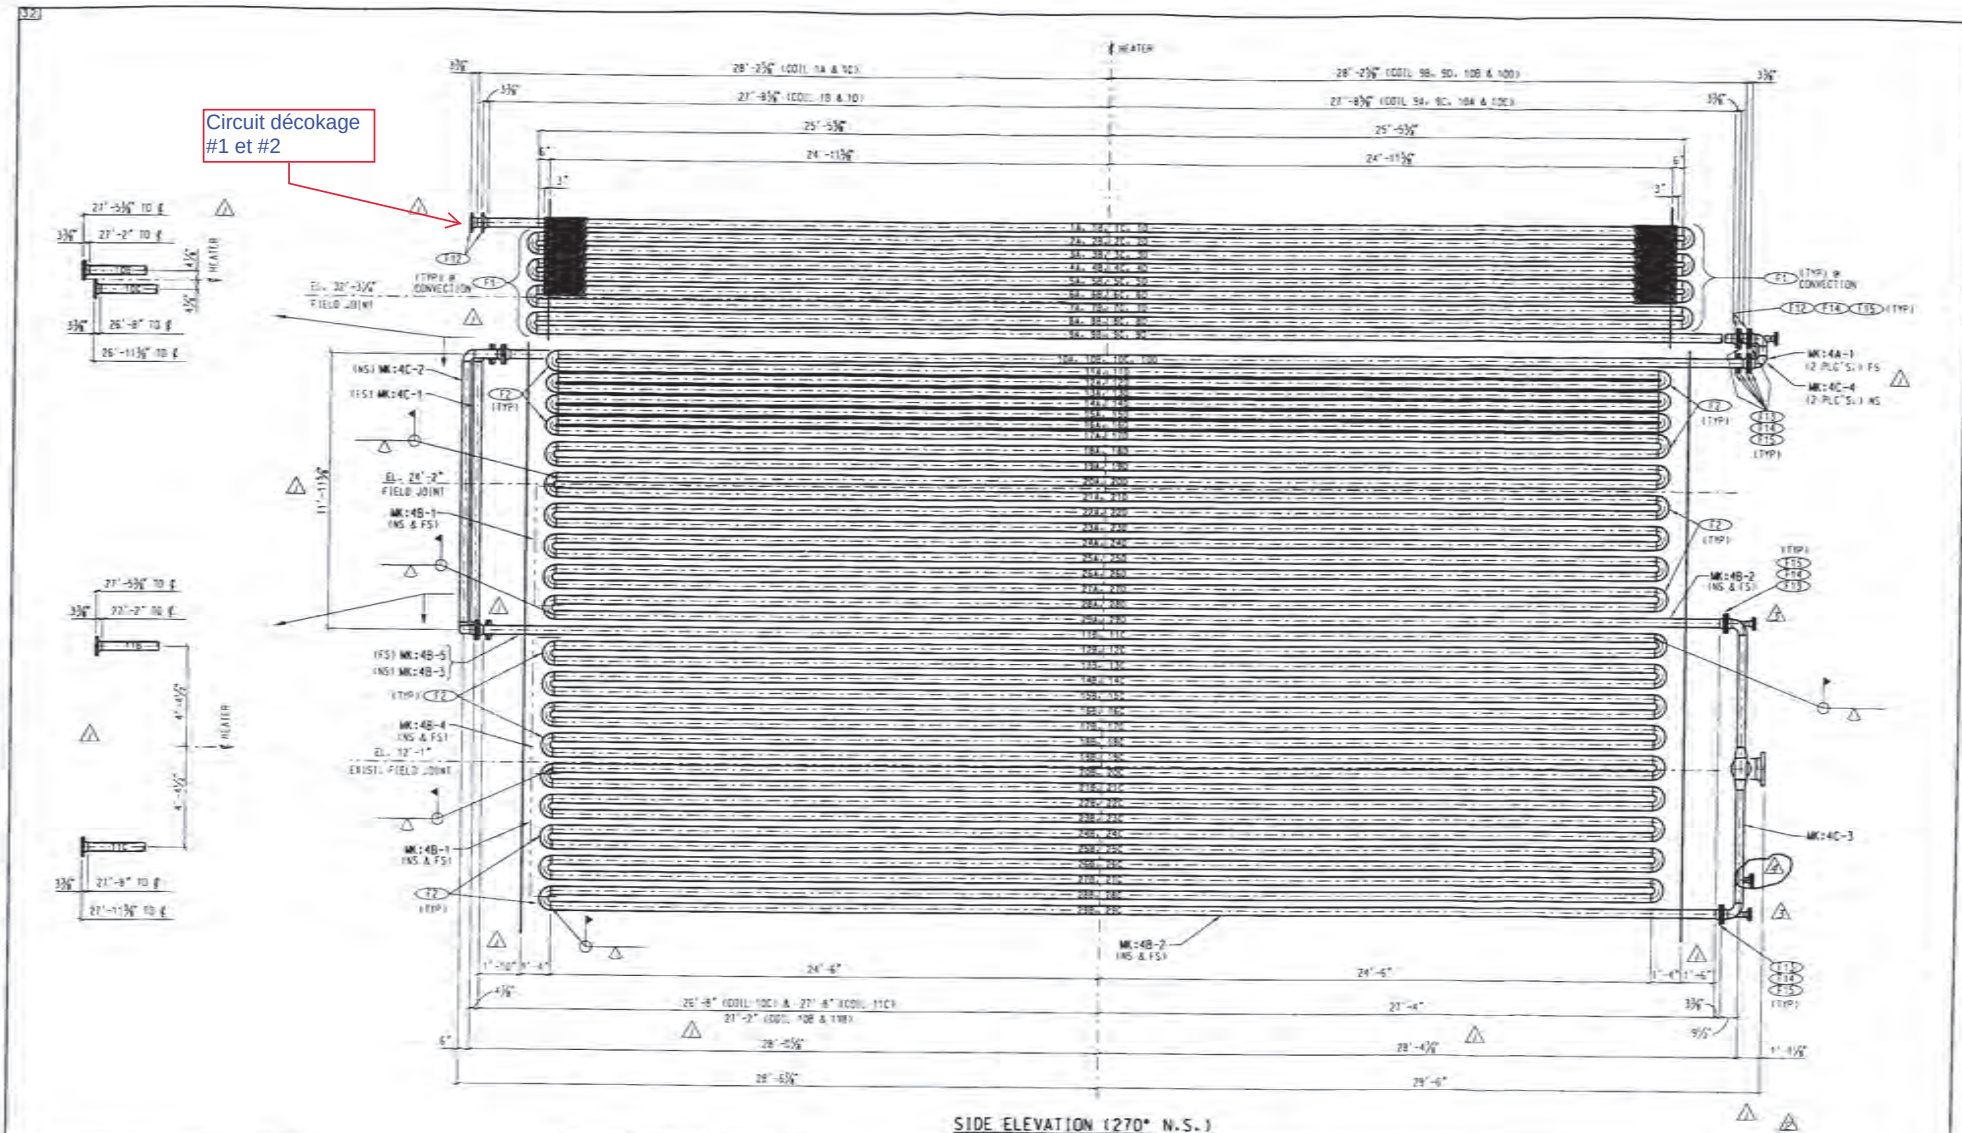

SIDE ELEVATION (270° N.S.)


PROPRIETARY INFORMATION
The information and designs shown herein, including all patented and proprietary features are the property of, proprietary and confidential to TULSA HEATERS, INC. This document and/or its contents shall not be reproduced in whole or in part, or disclosed to any third party without the express written consent of TULSA HEATERS, INC. All copies of this document, printed or electronic, are null and void if modified or altered in any way. Only TULSA HEATERS, INC. possesses the controlling document in its original, store and shall govern over any copy, printed or electronic.

- 4 - COIL BUNDLES MK-4B-1
- 4 - COILS MK-4B-2
- ONE - COIL MK-4B-3
- 2 - COIL BUNDLES MK-4B-4
- ONE - COIL MK-4B-5

Customer: BANTREL CO. / PETRO-CANADA PROJECT: MONTREAL CRUDE RECONFIGURATION LOCATION: MONTREAL REFINERY UNIT: CRUDE UNIT 100 SERVICE: CRUDE OIL HEATER EQUIP. NO.: 8-1001 P.O. NO.: 956-010-COIL-02A	<table border="1"> <tr> <th>Rev.</th> <th>Date</th> <th>By</th> <th>Description</th> </tr> <tr> <td>3/03</td> <td>BP</td> <td>REV'D.</td> <td>PER CUSTOMER COMMENTS</td> </tr> <tr> <td>4/03</td> <td>BP</td> <td>REV'D.</td> <td>PER CUSTOMER COMMENTS</td> </tr> <tr> <td>5/03</td> <td>BP</td> <td>REV'D.</td> <td>PER CUSTOMER COMMENTS</td> </tr> <tr> <td>6/03</td> <td>BP</td> <td>REV'D.</td> <td>PER CUSTOMER COMMENTS</td> </tr> </table>	Rev.	Date	By	Description	3/03	BP	REV'D.	PER CUSTOMER COMMENTS	4/03	BP	REV'D.	PER CUSTOMER COMMENTS	5/03	BP	REV'D.	PER CUSTOMER COMMENTS	6/03	BP	REV'D.	PER CUSTOMER COMMENTS
Rev.	Date	By	Description																		
3/03	BP	REV'D.	PER CUSTOMER COMMENTS																		
4/03	BP	REV'D.	PER CUSTOMER COMMENTS																		
5/03	BP	REV'D.	PER CUSTOMER COMMENTS																		
6/03	BP	REV'D.	PER CUSTOMER COMMENTS																		

THI TULSA
HEATERS
INC.


COIL DETAILS			
Drawn By	BP	Date	1/30/04
Checked By	DN	Date	2/5/04
Drawn No.	SJ731		
Drawn By	SJ731-4B 4		

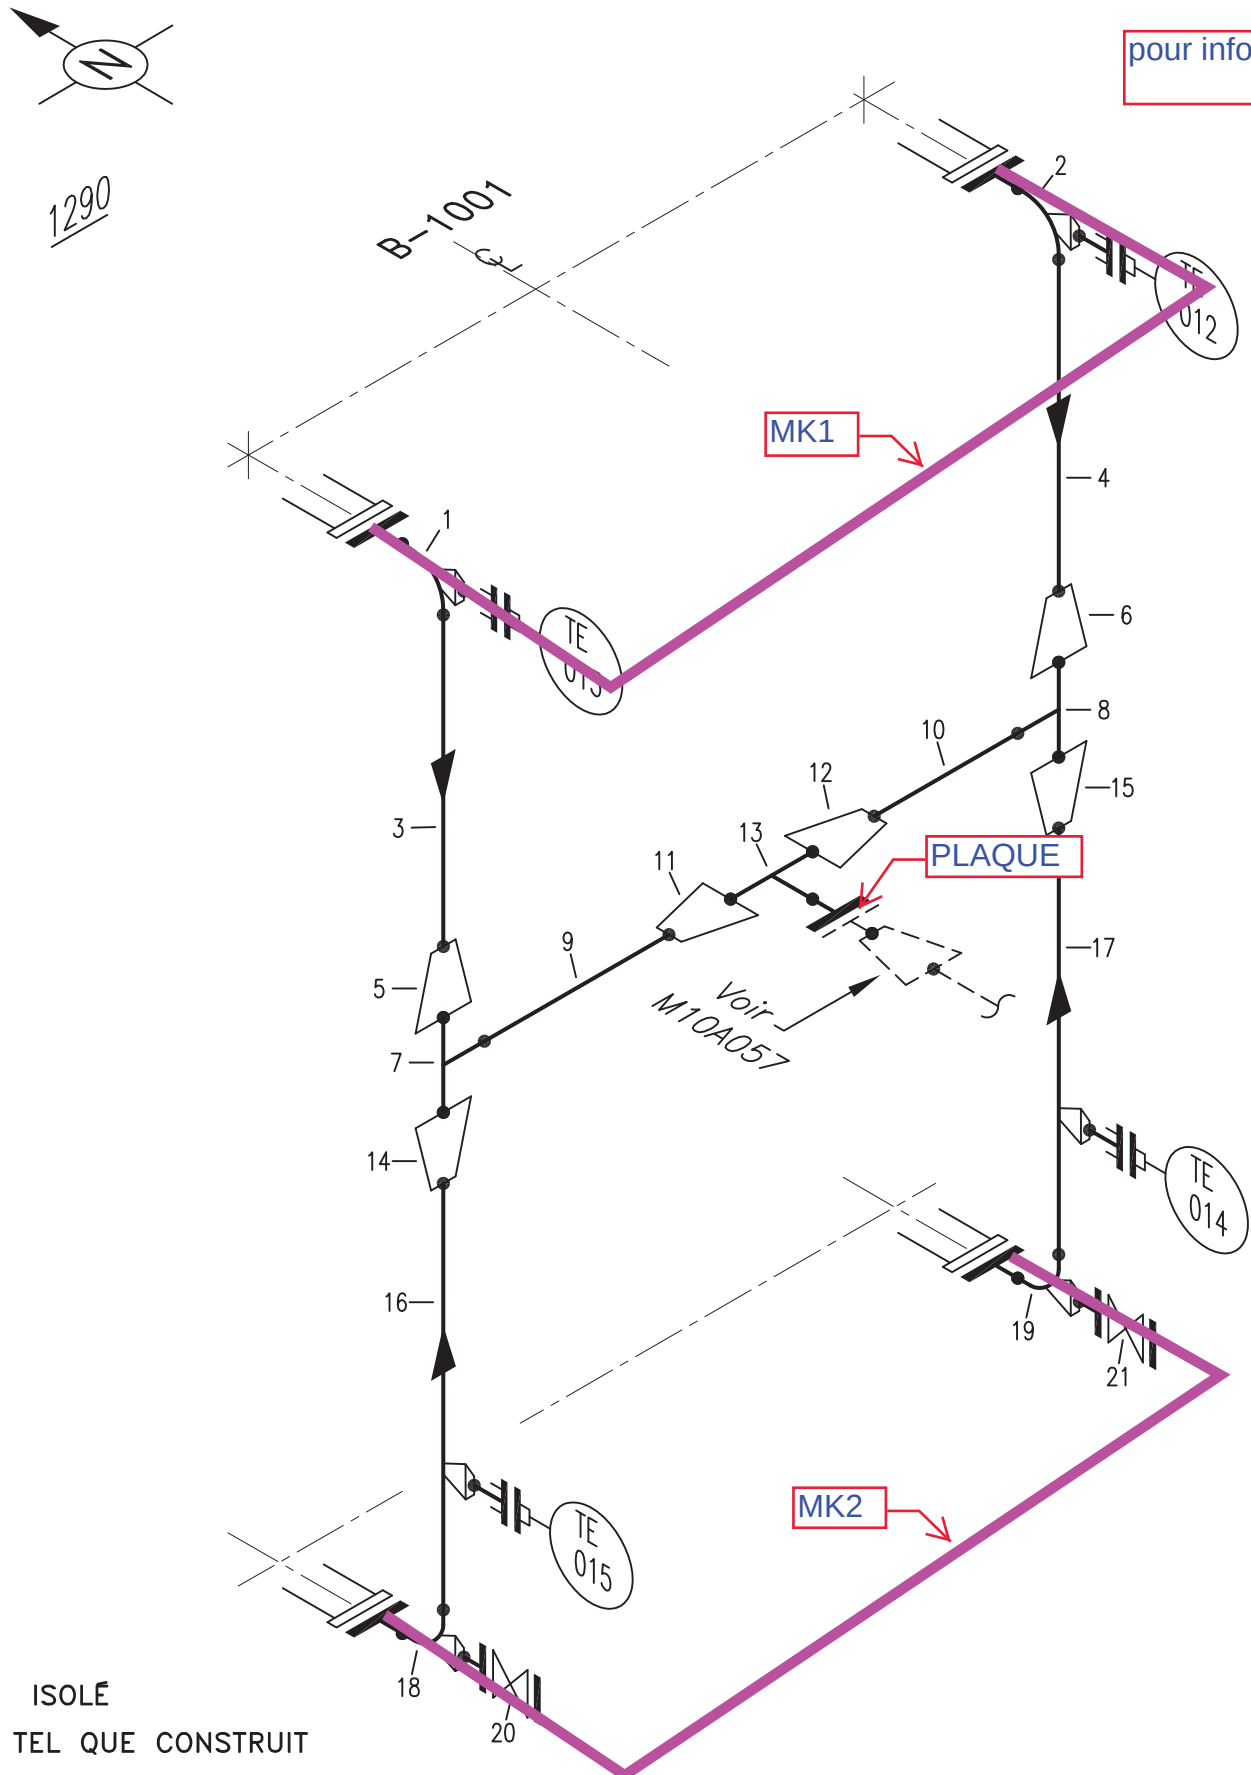


ISOLÉ
TEL QUE CONSTRUIT
MAI 2005

D.M.

Rev.0

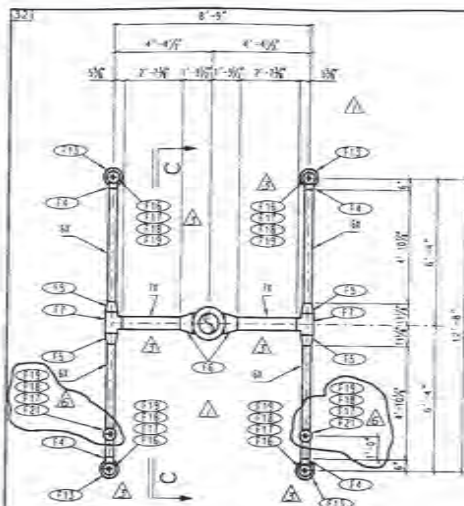


ONE OUTLET MANIFOLD - MK:4C-3

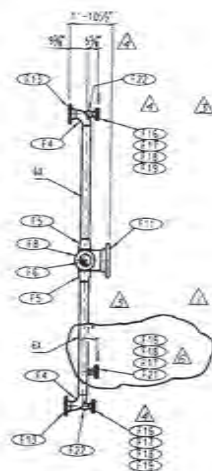


SECTION C - C


pour info

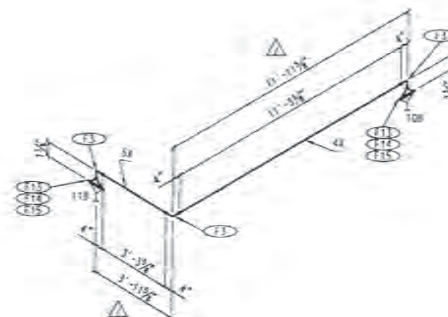


ONE - JUMPER - MK:4C-1

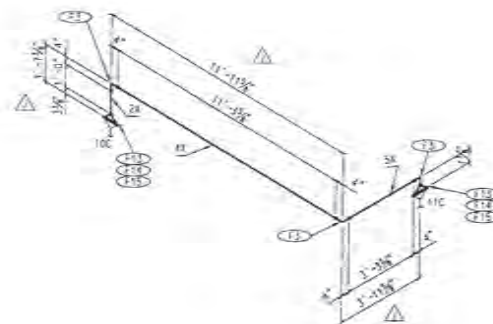

ONE - JUMPER - MK:4C-2

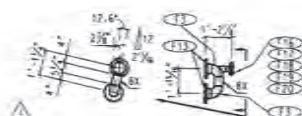

(2) CROSSOVERS - MK:4C-4
(SHIP LOOSE)

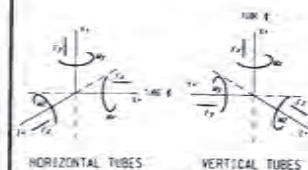


ALLOWABLE FORCES AND MOMENTS * NOZZLES (CONVECTION)					
F _x	F _y	F _z	M _x	M _y	M _z
LBS	LBS	LBS	FT-LB	FT-LB	FT-LB
200	400	400	800	450	700
ALLOWABLE MOVEMENTS (HORIZONTAL) (CONVECTION)					
D _x	D _y	D _z			
0"	0"	0"			
ALLOWABLE FORCES AND MOMENTS * 4" FLG. RADIANTS					
F _x	F _y	F _z	M _x	M _y	M _z
LBS	LBS	LBS	FT-LB	FT-LB	FT-LB
250	400	400	800	450	450
ALLOWABLE MOVEMENTS * 4" FLG. RADIANTS (HORIZONTAL)					
D _x	D _y	D _z			
0"	0"	0"			

PROPRIETARY INFORMATION
The information and designs shown herein, including all patented and patentable features are the property of, proprietary and confidential to TULSA HEATERS, INC. This document shall not be reproduced in whole or part, or disclosed to any third party without the express written consent of TULSA HEATERS, INC. All copies of this document, printed or electronic, are null and void if modified or altered in any way. Only TULSA HEATERS, INC. possesses the controlling document in its original form and shall govern over any copy, printed or electronic.

Rev.	By	Date	Description
1/2	BP	REV'D.	PER CUSTOMER COMMENTS
2/2	BP	REV'D.	PER CUSTOMER COMMENTS
3/2	BP	REV'D.	LOCATION OF 2" NOZZLE
4/2	BP	REV'D.	PER CUSTOMER COMMENTS
5/2	BP	REV'D.	PER CUSTOMER COMMENTS
6/2	BP	REV'D.	PER CUSTOMER COMMENTS

TULSA HEATERS INC.			
COIL DETAILS			
Rev.	By	Date	Description
1/2	BP	2/3/04	SJ731
2/2	BP	2/5/04	SJ731-4C16

pour info

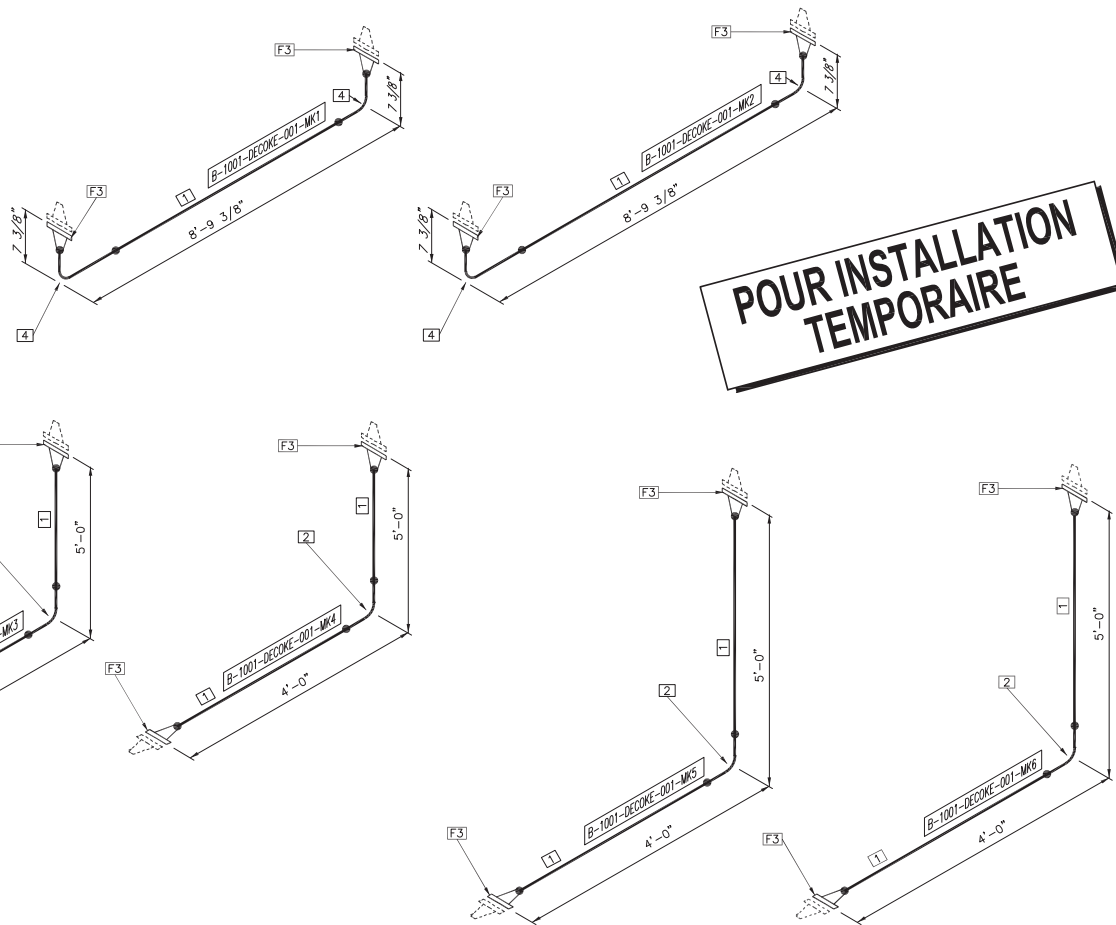

NOTES:

1. REGIE RBQ: NON
2. LES DIMENSIONS EN CHANTIER DOIVENT ETRE VALIDEES AVANT FABRICATION.
3. INSTALLER UNE PLAQUE D'IDENTIFICATION EN SS SUR CHAQUE SPOOL ET Y INSCRIRE:
 - NO ISOMETRIQUE: 100-600B1477
 - NO SPOOLS: B-1001-DECOKE-001-MK1 ET/OU B-1001-DECOKE-001-MK2
 - ET/OU B-1001-DECOKE-001-MK3 ET/OU B-1001-DECOKE-001-MK4
 - ET/OU B-1001-DECOKE-001-MK5 ET/OU B-1001-DECOKE-001-MK6
 - SPEC: UD1
 - ANNEE DE FABRICATION
4. PEINDRE LE SPOOL TEMPORAIRE DE COULEUR: ORANGE FLUORESCENT.

LISTE DE MATERIEL

No	QTE	DIA	DESCRIPTION	NORME / CODE
1	46'4"	4	Pipe, A106-B, SMLS, Sch Std, BBE	ASME B36.10M
2	4	4	El - 90, LR, BW, A234-WPB, Sch Std	ASME B16.9
3	12	4	WN Flg, A105N, CL300, Sch Std, RF	ASME B16.5
4	4	4	SCH STD SMLS FS 90 DEG SR ELBOW, A-234 GR WPB (HORS-SPEC)	ASME B16.9

1	2018 13 NOV	DESSIN SPOOLS TEMPORAIRES EMIS POUR PLAN FINAL (60086947)	MeG	CFL	K. HAMDAN	
No.	DATE	REVISION	PAR	VERIF	ING. PROJET No. Enregistrement	APPR
			CONCEPTEUR G. TREMBLAY (TUMEC)			
			DESSINATEUR ME. GATINEAU			
			VERIFICATEUR CHANFER LY			
			SUPERVISEUR ING. S. ARCAND			
UNITE 100 VISCOREDUCTION SPOOLS TEMPORAIRES POUR DECKAGE B-1001 B-1001-DECOKE-001-MK1@MK6			DATE 2018-11-13			
			ECHELLE AUCUNE			
			CLASSE M	No. DE DESSIN 100-600B1477		REV 1

NO. DE CONDUITE		SUNCOR SPECIFICATION	PRODUIT	SYSTEME REVETEMENT	CODE DE COULEUR	ISOLATION ET TRACAGE	EPAISS. D'ISOLATION - MATERIEL		SUNCOR CLASSE INSPECTION / END
B-1001-DECOKE-001-MK1@MK6		UD1	EAU, SODA, ASH	NC9	NOTE 4	N/A	N/A	- N/A	SIII
M.D.M.T.	PRESSION D'OPERATION	TEMPERATURE D'OPERATION	PRESSION DE CONCEPTION	TEMPERATURE DE CONCEPTION	PRESSION D'ESSAI	CODE DE SERVICE D'INSPECTION	TRAITEMENT THERMIQUE	ALLOCATION DE CORROSION	CODE DE FABRICATION ET REPARATION
-20 °F	370 PSIG	120 °F	700 PSIG	170 °F	1050 PSIG	-	NON	0.0625	B31.3 2016
									RT 10%

